

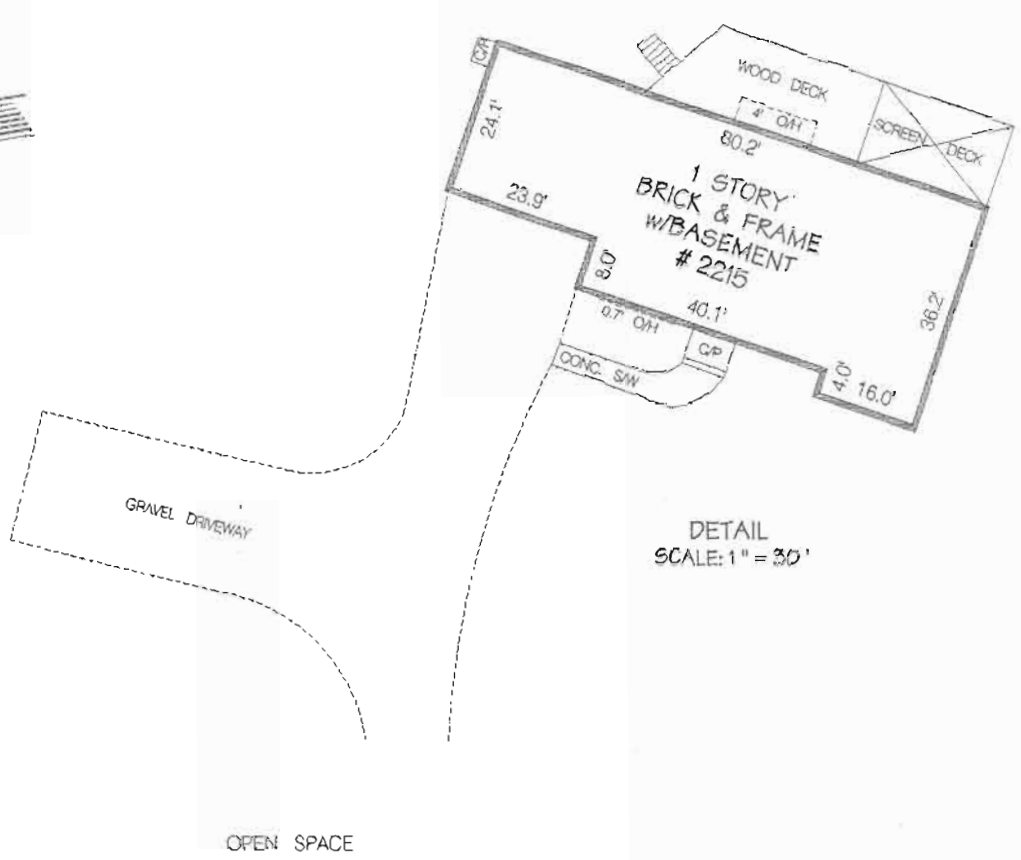



This plat is of benefit to a consumer only insofar as it is required by a lender or a title insurance company or its agent in connection with contemplated transfer, financing or refinancing. This plat is not to be relied upon for the establishment or location of fences, garages, buildings or other existing or future improvements. Fences shown hereon as ~~---~~ or ~~---~~ are approximate only. The exact location of fences and the existence of property corner markers can only be determined with the benefit of a boundary survey. This plat does not provide for the accurate identification of property boundary lines, but such identification may not be required for the transfer of title or securing financing or refinancing. This plat shows only those improvements observed during a brief inspection on the date indicated. Possible building setback violations are not fully examined as part of these services. A licensee was in responsible charge over the preparation of this drawing and surveying work reflected therein which was done in accordance with the Maryland State Minimum Standards of Practice for Land Surveyors. No title search or abstract furnished to or done by this company. The right to use or rely upon this drawing or the information on it for any purpose shall expire in 180 days from its date. This survey document shall not be considered valid or used for any purpose until its fee is paid, as it shall be considered incomplete until such time as the aforesaid transaction is consummated.

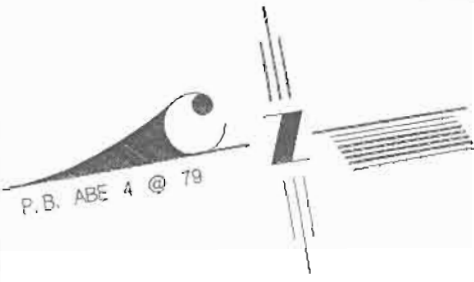

DETAIL
SCALE: 1" = 30'

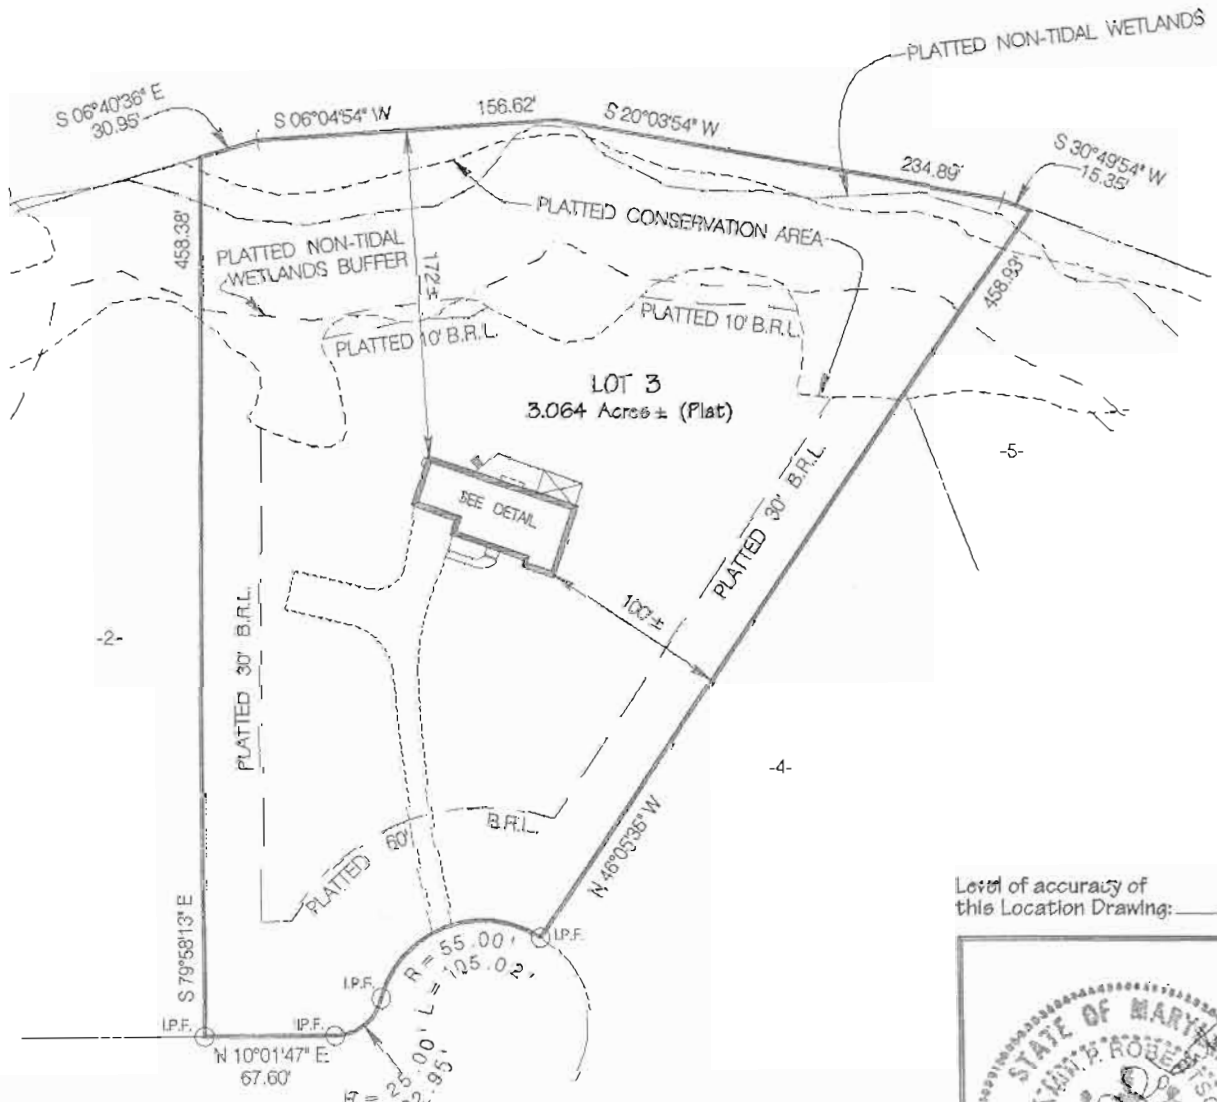

Level of accuracy of this Location Drawing: 2' ±

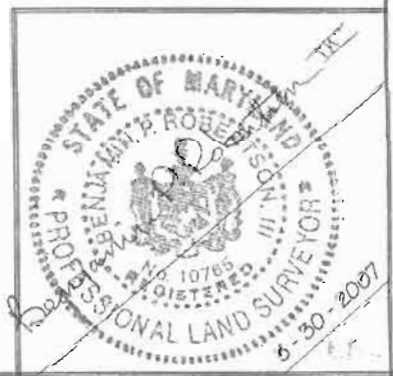

HIDDEN RETREAT TRAIL
(50' R.W.)

RECORDED IN: PLAT BOOK, ABE 4, @ 79

LOCATION DRAWING
LOT 3 FINAL PLAT
HIDDEN RETREAT
CALVERT COUNTY, MARYLAND
Job No. CA - 6849 - A

RDA
 REAL ESTATE DEVELOPMENT TECHNOLOGY ASSOCIATES, INC.
 ENGINEERS • LAND PLANNERS • LAND SURVEYORS
 65 DUKE STREET, SUITE 204
 PRINCE FREDERICK, MARYLAND 20678
 PHONE (301) 855-9500 (410) 535-8600
 copyright © 2007 by RDA

Scale: 1" = 100'